


REVISIONS NO.	DATE	PURPOSE
▲	04-21-2015	PLAN CHECK
▲	05-18-2015	PLAN CHECK

DRAWN BY	BC
CHECKED	RSR
SCALE	1" = 20'-0"
DATE	04.30.2015
JOB	12005.00

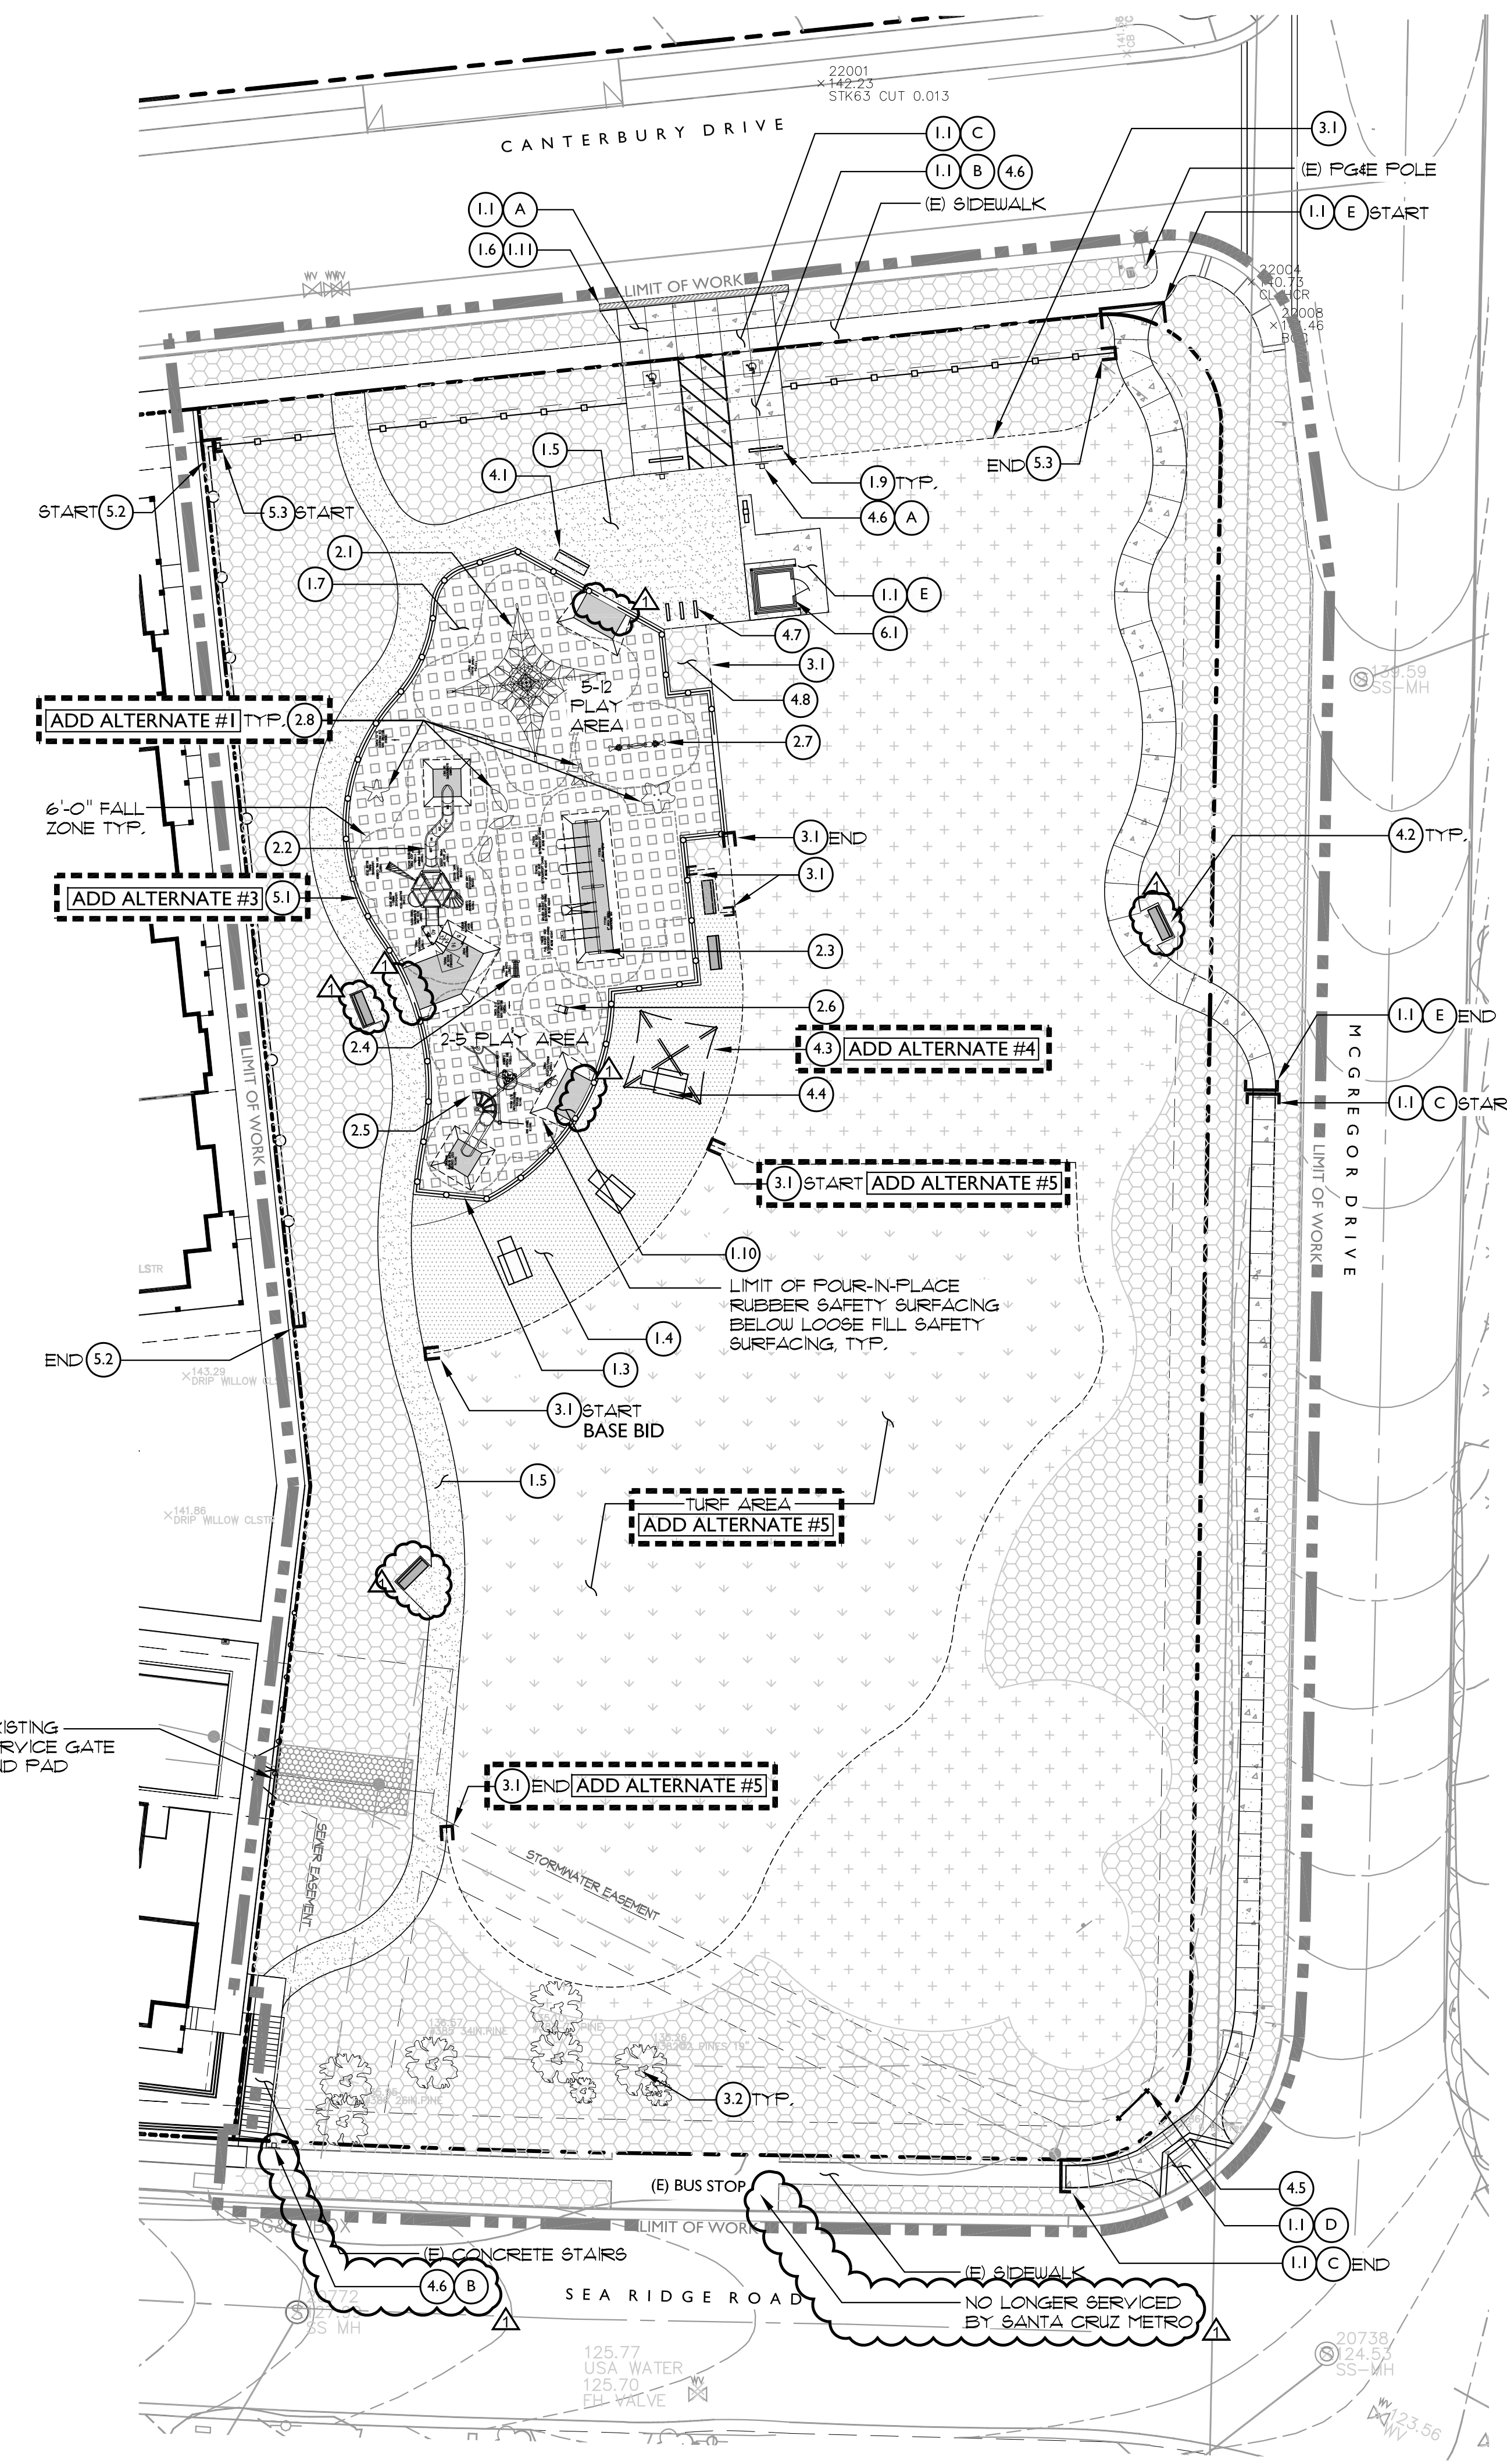

SITE PLAN LEGEND

SYMBOL	DESCRIPTION	SYMBOL	DESCRIPTION
---	LIMIT OF WORK	□	SPLIT RAIL FENCE PER NOTE 5.3
○	DETAIL REFERENCE SHEET REFERENCE	○	CHAIN LINK FENCE PER NOTE 5.3 [ADD ALTERNATE #3]
□	STANDARD CONCRETE PER NOTE 1.1	○	SOLID WOOD 'GOOD NEIGHBOR' FENCE PER NOTE 5.2
□	PERVIOUS CONCRETE PER SPECIFICATIONS AND NOTE 1.5	—	BENCH 4.1
□	LOOSE FILL SAFETY SURFACING PER NOTE 1.7	—	MEMORIAL BENCH, N.I.C. PER NOTE 4.2
□	FOUR-IN-PLACE RUBBER SAFETY SURFACING PER NOTE (BID ALT.) 1.10	□	PICNIC TABLE ADA ACCESSIBLE PER NOTE 4.4
□	STABILIZED DECOMPOSED GRANITE PER SPECIFICATIONS AND NOTE 1.4		BIKE RACK PER NOTE 4.7
□	ASPHALT PATCH PER NOTE 1.6	□	TEMPORARY RESTROOM W/ LATTICE SCREEN 5.4 6.1
□	TURF GRASS PER PLANTING PLAN L-8.0 [ADD ALTERNATE #5]	□	SHADE UMBRELLA PER NOTE 4.3
□	NATIVE PLANTING AREA PER PLANTING PLAN L-8.0		
□	TEMPORARY NATIVE HYDROSEED PER PLANTING PLAN L-8.0		
□	(E) ALL WEATHER SERVICE PAD		

ADA SIGNING/STRIPING NOTES

- ALL STRIPING AND PAVEMENT MARKINGS SHALL BE INSTALLED IN ACCORDANCE WITH THE CALTRANS STANDARD SPECIFICATIONS AND STANDARD PLANS (2010), THE 2010 CALIFORNIA MANUAL ON UNIFORM TRAFFIC CONTROL DEVICES (MUTCD), THE PROJECT SPECIFICATIONS AND THE COUNTY OF SANTA CRUZ STANDARD SPECIFICATIONS.
- ALL SIGNS SHALL BE SIZED AND CONSTRUCTED IN ACCORDANCE WITH THE MUTCD AND THE CALTRANS STANDARD PLANS AND SPECIFICATIONS.

MATERIALS & FINISHES SCHEDULE

ALL FURNITURE, FIXTURES & EQUIPMENT ARE LISTED BELOW OR APPROVED EQUAL

DETAIL	1.0 HARDSCAPE	DETAIL	3.0 PLANTING
(1.1)	STANDARD CONCRETE TO RECEIVE LAMP BLACK PER SPECIFICATIONS. FINISH TO BE MEDIUM BROOM PERPENDICULAR TO PRIMARY PATH OF TRAVEL.	(3.1)	'HEADERBOARD' TO BE 2X4 REDWOOD
(A)	OFF-SITE DRIVEWAY SECTION PER COUNTY DESIGN CRITERIA DRAWING ST-60	(3.2)	'EXISTING TREE' TO REMAIN
(B)	ON-SITE DRIVEWAY SECTION PER DETAILS		4.0 SITE FURNISHINGS
(C)	OFF-SITE SIDEWALK SECTION PER COUNTY DESIGN CRITERIA DRAWING ST-48	(4.1)	'BENCH' TO BE 6'-0" LONG RECYCLED PLASTIC '103-60 FL'. 8-1 EMBEDMENT BY DUMOR CONTACT CASEY HILBERT WITH ROSS RECREATION (831) 689-910. QUOTE #00006272.
(D)	CURB RAMP, TYPE D PER COUNTY DESIGN CRITERIA DRAWING ST-8d. SEE CIVIL PLANS FOR ADDITIONAL INFORMATION	(4.2)	'MEMORIAL BENCH - N.I.C.' TO BE 6'-0" BENCH '88-60 FL'. COLOR TO BE BLACK STEEL REDWOOD FLANKS. 8-1 EMBEDMENT BY DUMOR CONTACT CASEY HILBERT WITH ROSS RECREATION (831) 689-910. 3' X 8' PLAQUE INSERT. TO BE FURNISHED AND INSTALLED BY OTHERS.
(E)	ON-SITE PEDESTRIAN SECTION PER DETAILS	(4.3)	'SHADE UMBRELLA' TO BE 'CIRCULAR RACK WCR02-8F' IN COLOR 'BRONZE' TO BE SURFACE MOUNTED BY USA SHADE & FABRIC STRUCTURES, INC. CONTACT CASEY HILBERT WITH ROSS RECREATION (831) 689-910. QUOTE #00007849 [ADD ALTERNATE #4]. CONTRACTOR IS RESPONSIBLE FOR BUILDING PERMIT. REFER TO THE COVER SHEET FOR MORE INFORMATION.
(1.2)	NOT USED	(4.4)	'ADA PICNIC TABLE' TO BE RECYCLED PLASTIC TABLE '100-681 FL'. SURFACE MOUNTED BY DUMOR CONTACT CASEY HILBERT WITH ROSS RECREATION (831) 689-910. QUOTE #00006272.
(1.3)	'CONCRETE CURB' TO RECEIVE SOLQMON COLOR 'C-25 SOMBRERO BUFF' PER SPECIFICATIONS. FINISH TO BE MEDIUM BROOM PERPENDICULAR TO CURB LENGTH.	(4.5)	'PHASE I PARK SIGN' PER COUNTY STANDARDS
(1.4)	'DECOMPOSED GRANITE' TO BE STABILIZED GRANITECTRE COLOR TO BE 'NATURAL'. INSTALL PER MANUFACTURER'S RECOMMENDATIONS AND SPECIFICATIONS	(4.6)	'ACCESSIBLE PARKING SIGNAGE & STRIPING' PER SPECIFICATIONS
(1.5)	'PERVIOUS CONCRETE PAVING' TO RECEIVE SOLQMON COLOR 'C-25 SOMBRERO BUFF' PER SPECIFICATIONS	(A)	'PARKING' PER DETAILS AND SPECIFICATIONS.
(1.6)	NOT USED	(B)	'DIRECTIONAL' PER DETAILS AND SPECIFICATIONS
(1.7)	'LOOSE FILL SAFETY SURFACING' TO BE BY FIBAR PLAYGROUND SURFACES (800) 342-2721 PER SPECIFICATIONS	(4.7)	'BIKE RACK' TO BE 'CIRCULAR RACK WCR02-8F' IN COLOR 'BLACK' TO BE SURFACE MOUNTED BY WELLE CONTACT PALMER GROUP (418) 333-6428
(1.8)	'PARKING STRIPING' PER SPECIFICATIONS	(4.8)	'PUBLIC ART COMPONENT - N.I.C.' COORDINATE WITH PUBLIC ARTIST AS REQUIRED
(1.9)	'CONCRETE WHEEL STOPS' PER SPECIFICATIONS	(4.9)	'DRINKING FOUNTAIN' TO BE MODEL #840-8M88-01' IN COLOR 'BLACK' BY MOST DEPENDABLE FOUNTAINS
(1.10)	'PLAY AREA SAFETY SURFACING' FOUR-IN-PLACE RUBBER SAFETY SURFACING BY SURFACE AMERICA COLORS 'ED. CONTACT JUDY OGBURN WITH ROSS RECREATION (707) 538-3800. (BID ALTERNATE)		5.0 FENCING
(1.11)	'DRIVEWAY APRON' PER COUNTY STANDARD FIGURE ST-6C, MODIFIED PER THE DIMENSIONS SHOWN ON PLANS	(5.1)	'CHAIN LINK FENCE' 4'-0" TALL BLACK VINYL PER SPECIFICATIONS [ADD ALTERNATE #3]
	2.0 PLAY EQUIPMENT	(5.2)	'GOOD NEIGHBOR WOOD FENCE' PER COUNTY STANDARDS
(2.1)	'LUNAR BURST CLIMBING NET' #173754	(5.3)	'SPLIT RAIL FENCE' TO BE CEDAR, 'SPLIT RAIL AND POST' TYPE
(2.2)	'5-12 CUSTOM LIGHTHOUSE THEMED PLAY STRUCTURE' PLAYBOOSTER CUSTOM STRUCTURE	(5.4)	'LATTICE SCREEN' TO BE 8' TALL REDWOOD OR FR
(2.3)	'DOUBLE BAY SWINGS' ARCH SWING FRAME, 2 BAYS, 2 BELT SEATS, 1 FULL BUCKET SEAT, 1 MOLDED BUCKET SEAT #177330		6.0 STRUCTURES
(2.4)	'CLEAR PAINT PANEL' FREESTANDING SENSORY PLAY #12621A-B	(6.1)	'TEMPORARY RESTROOM (AKA PORT-A-POTTY)' WITH LATTICE SCREEN TO BE 'ADA UNIT' BY D&G SANITATION. INSTALL PER MANUFACTURER'S INSTRUCTIONS. PRIOR TO INSTALLATION, THE CONTRACTOR SHALL SUBMIT SHOP DRAWINGS THAT DEMONSTRATE THE PRODUCT COMPLES WITH CBC 11B-603 AND THE AMERICANS WITH DISABILITIES ACT (ADA).
(2.5)	'2-5 WEEVOS STRUCTURE' CUSTOM STRUCTURE		
	PLAY EQUIPMENT (2.1 - 2.5) PROVIDED BY LANDSCAPE STRUCTURES. INSTALL PER MANUFACTURER'S RECOMMENDATIONS. CONTACT CASEY HILBERT WITH ROSS RECREATION (831) 689-910 QUOTE #00006272. SEE LAYOUT PLAN, SHEET L-6.0 FOR FALL HEIGHTS		
(2.6)	'SHARK SPRINGER' INDEPENDENT PLAY BY KOMPAN #M167P		
(2.7)	'OCTOPUS SEE-SAW' INDEPENDENT PLAY BY KOMPAN #M181P		
(2.8)	'CUSTOM PRECAST CONCRETE FISH AND STARFISH' PROVIDED BY UNIVERSAL PRECAST CONCRETE. INSTALL PER MANUFACTURER'S RECOMMENDATIONS. CONTACT MARGARET BROWN WITH WONDERSCAPES RECREATION, INC. (707) 887-9262. CONTRACTOR MUST SUBMIT SHOP DRAWINGS TO COUNTY FOR APPROVAL.		

